


PROJECT: Well No. 10 Drilling & Construction	CLIENT: City of Whitehorse	HOLE NO: <b>Well 10</b>
LOCATION: Selkirk Aquifer UTM N 6,729,185.0 E 498,824.0		PROJECT NO.: 5140576
CONTRACTOR: Midnight Sun Drilling Ltd.	METHOD: Air Rotary	GROUND ELEVATION (m): 656
BACKFILL TYPE	<input checked="" type="checkbox"/> BENTONITE <input type="checkbox"/> GRAVEL <input type="checkbox"/> SLOUGH <input type="checkbox"/> GROUT <input type="checkbox"/> CUTTINGS <input type="checkbox"/> SAND	



BOREHOLE AND WELL LOG - GINT-06-11-2014-COWWELL\_NO 10 BH LOG - CL-5140576.GPJ - AECOM - BBY - 2011.GDT - 07/11/14

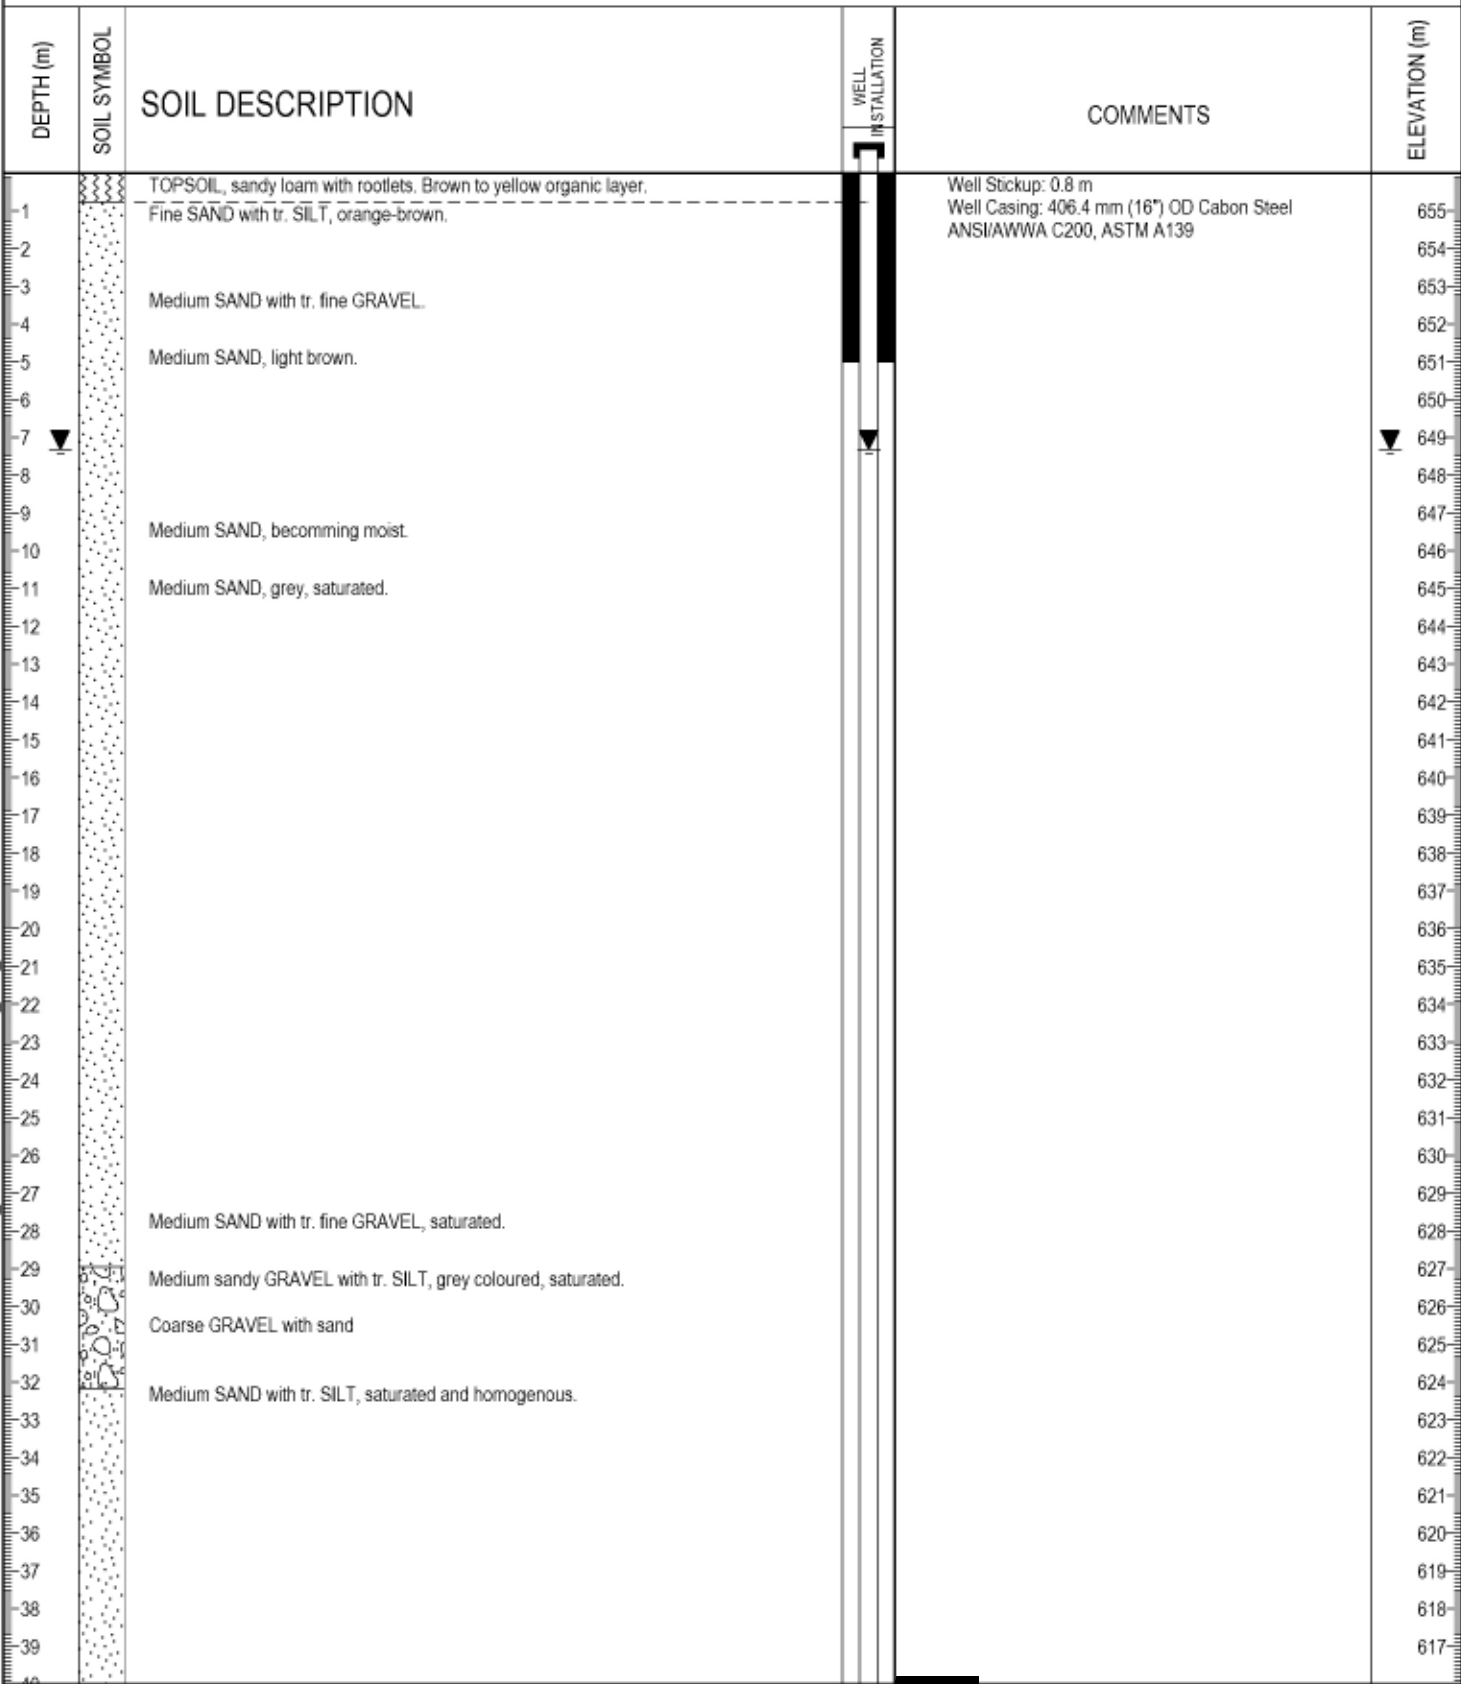

MORRISON HERSHFIELD

LOGGED BY: [REDACTED]	COMPLETION DEPTH: 62.48 m
REVIEWED BY: [REDACTED]	COMPLETION DATE: 09/05/14
PROJECT GEOSCIENTIST: [REDACTED]	Page 1 of 2

PROJECT: Well No. 10 Drilling & Construction	CLIENT: City of Whitehorse	HOLE NO: <b>Well 10</b>
LOCATION: Selkirk Aquifer UTM N 6,729,185.0 E 498,824.0		PROJECT NO.: 5140576
CONTRACTOR: Midnight Sun Drilling Ltd.	METHOD: Air Rotary	GROUND ELEVATION (m): 656
BACKFILL TYPE	<input checked="" type="checkbox"/> BENTONITE	<input type="checkbox"/> GRAVEL
	<input type="checkbox"/> SLOUGH	<input type="checkbox"/> GROUT
	<input type="checkbox"/> CUTTINGS	<input type="checkbox"/> SAND


DEPTH (m)	SOIL SYMBOL	SOIL DESCRIPTION	WELL INSTALLATION	COMMENTS	ELEVATION (m)
-41		Coarse GRAVEL, some cobbles and sand present. Grey coloured and saturated.		Well Screen Details: Screen Length: 9.144 m Screen OD: 355 mm (14") Slot: 160-slot (4.064 mm) Material: Stainless Steel, V-Wire continuous wrap construction.	615
-42					614
-43					613
-44					612
-45					611
-46					610
-47					609
-48					608
-49					607
-50					606
-51					605
-52					604
-53					603
-54		602			
-55		601			
-56		600			
-57		599			
-58		598			
-59		597			
-60		596			
-61		595			
-62		594			
-63		end of hole			593
-64					592
-65					591
-66					590
-67					589
-68					588
-69					587
-70					586
-71					585
-72					584
-73					583
-74					582
-75					581
-76					580
-77					579
-78					578
-79					577
-80					

BOREHOLE AND WELL LOG - GINT-06-11-2014-COWWELL NO 10 BH LOG - CL-5140576.GPJ - AECOM - BBY - 2011.GDT - 07/11/14



MORRISON HERSHFIELD

LOGGED BY:	COMPLETION DEPTH: 62.48 m
REVIEWED BY:	COMPLETION DATE: 09/05/14
PROJECT GEOSCIENTIST:	Page 2 of 2

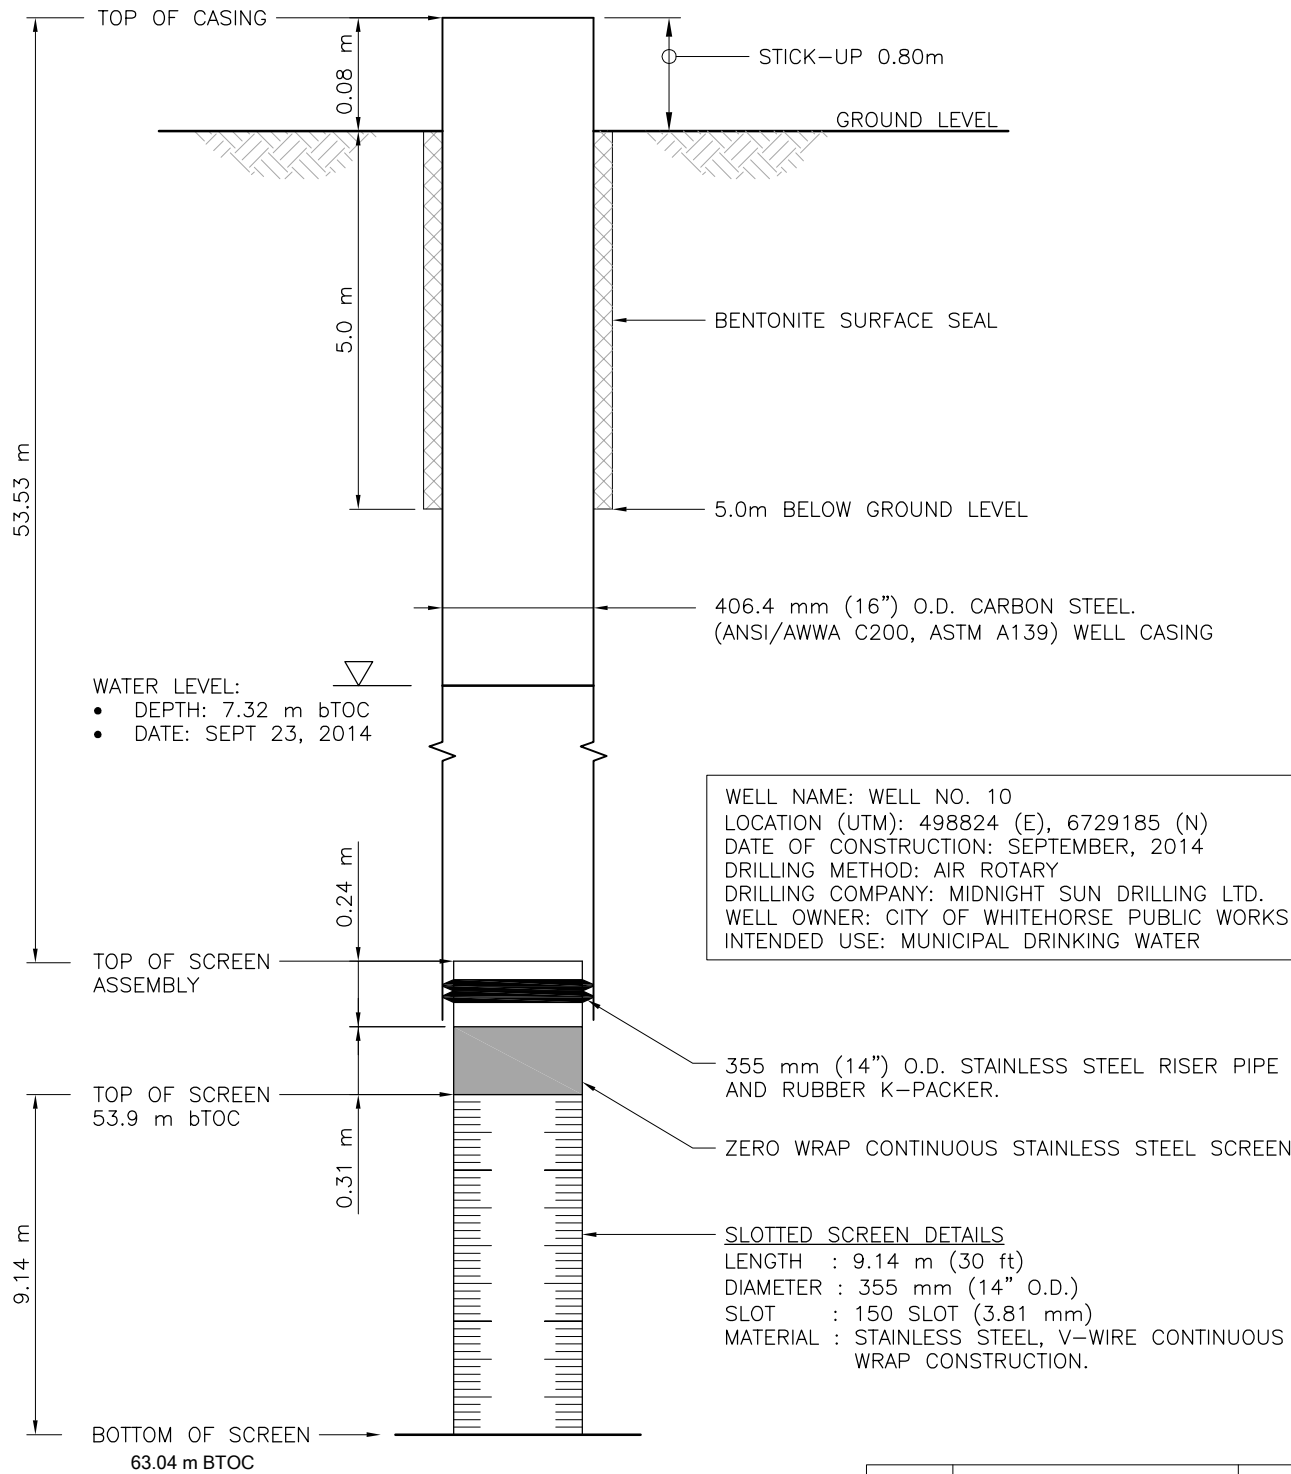

WELL NAME: WELL NO. 10  
 LOCATION (UTM): 498824 (E), 6729185 (N)  
 DATE OF CONSTRUCTION: SEPTEMBER, 2014  
 DRILLING METHOD: AIR ROTARY  
 DRILLING COMPANY: MIDNIGHT SUN DRILLING LTD.  
 WELL OWNER: CITY OF WHITEHORSE PUBLIC WORKS  
 INTENDED USE: MUNICIPAL DRINKING WATER

A	FINAL	14-11-27
ISSUE	DESCRIPTION	DATE

**Notes:**  
 ID - INNER DIAMETER  
 BTOC - BELOW TOP OF CASING  
 OD - OUTER DIAMETER

Design: —  
 Drawn: —  
 Reviewed: —  
 Scale: NTS  
 Date: 27-11-14

Client:

**CITY OF WHITEHORSE**  
**WELL No. 10**  
**WELL CONSTRUCTION RECORD DRAWING**

Project No.: 5140576.00      Drawing No. 1

Suite 202, 208 Main Street,  
 Whitehorse, Yukon Y1A 2A9  
 www.morrisonhershfield.com  
 Tel: 867 456 4747 Fax: 867 456 4760

\\van01fp.mh.local\data1\Shared\pfd01\5140576\Drawing\COW\_Well\_No\_10.dwg 1/9/2012 11:49 AM