


**ROSS RIVER  
LITHOLOGY**

Depth (m)	Lithology	Comments
0 - 2.7	Till - sandy - silty, pebbles to 15 mm, gravel lens from 2.1 - 2.74 m (no noticable water)	
2.7 - 8.2	Till - dry, sandy to 4.57 m increase in moisture, dark grey, top of permafrost at approximately 8.23 m	Begin injecting water at 7.62 m
8.2 - 18.5	Till - sandy, silty, some bedrock	
18.5 - 60.0	Till - silty clay, some sand, black, continue injecting water	
60.0 - 101.5	Till - silty sandy, some clay, becomes saturated with depth	Sand is running and sloughing on each connection
101.5 - 110.0	Gravel to 25 mm size, round to sub-round, producing water in excess of 25 L/sec	

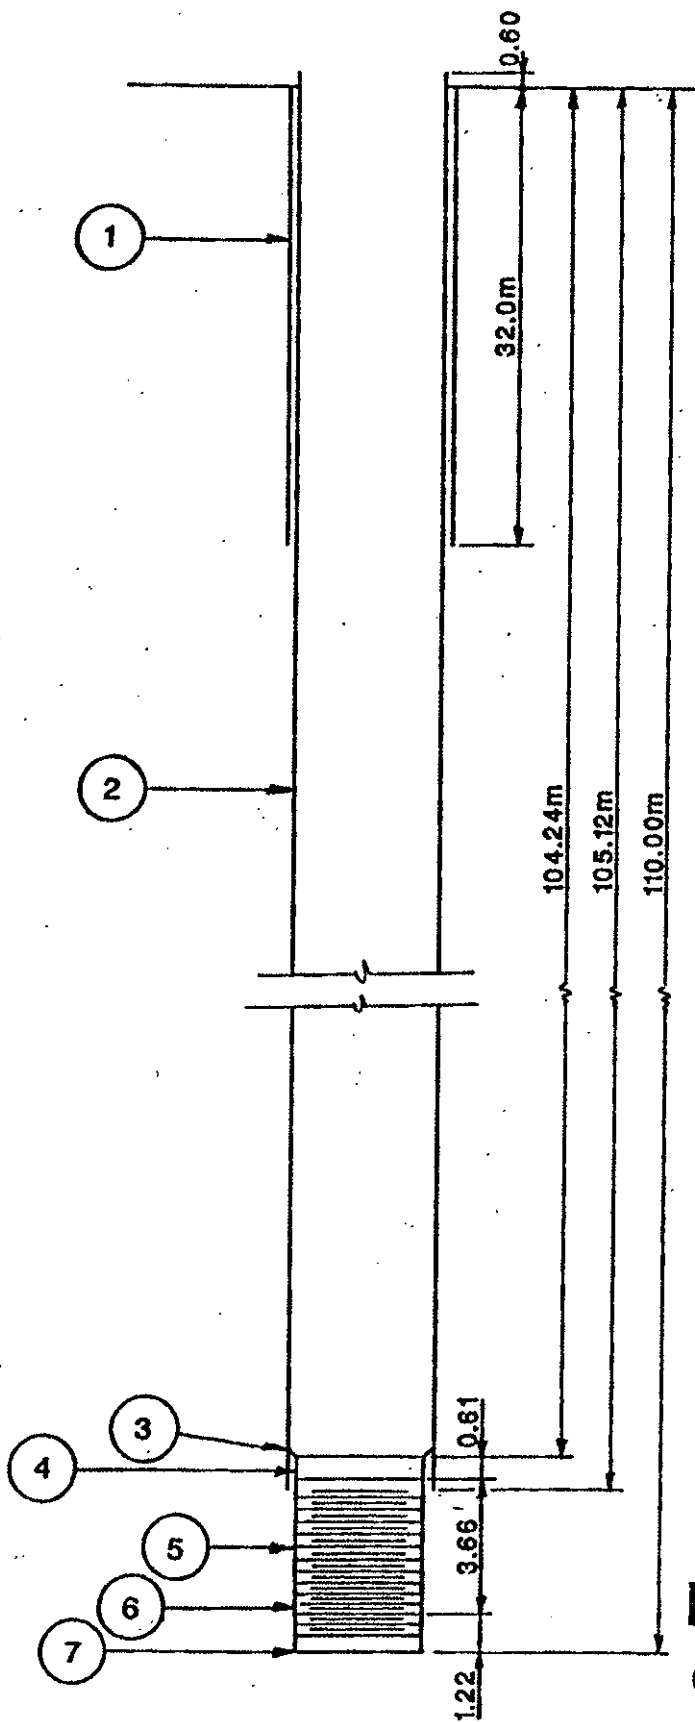

**KEYNOTES**

- 1 203mm O.D. STEEL CASING
- 2 168mm O.D. X 0.280mm WALL STEEL CASING
- 3 JOHNSON LEAD PACKER
- 4 141mm O.D. STEEL RISER
- 5 143mm O.D. X 124mm I.D. STAINLESS STEEL WELL SCREEN SLOTTED 0.64mm
- 6 143mm O.D. X 124mm I.D. STAINLESS STEEL WELL SCREEN SLOTTED 0.76mm
- 7 END CAP

**ROSS RIVER WATER WELL COMPLETION DETAILS**

Hydrogeological Assessment      Yukon Government Community Services      PROJECT NO. - BOREHOLE NO.

Community Well      DRILL: Air Rotary      [REDACTED]

Ross River, YT      6874867N; 633543E; Zone 8


SAMPLE TYPE     DISTURBED     NO RECOVERY     SPT     A-CASING     SHELBY TUBE     CORE

BACKFILL TYPE     BENTONITE     PEA GRAVEL     SLOUGH     GROUT     DRILL CUTTINGS     SAND


Depth (m)	SOIL DESCRIPTION	SAMPLE TYPE	SAMPLE NUMBER	TEMP (°C)	SPT (N)	STANDARD PENETRATION (N)			GROUND ICE DESCRIPTION	Depth (ft)
						20	40	60		
0	SAND AND GRAVEL - trace silt								SEASONALLY FROZEN	0
1		X	1		20				UNFROZEN	5
2		X	2		9					10
3		X	3	0.2	9					15
4	SILT - some clay to SILT, clayey	X	4	1.7	6					20
5		X	5	1.9	6					25
6		X	6	-0.1	21				PERMAFROST with occasional ice lenses	30
7		X	7	-0.2	20					35
8		X	8	2.2	6				UNFROZEN	40
9		X	9	0.7	9					45
10		X	10	0.9	11					50
11		X	11	2.5	17					55
12	SAND	X	12	3.2	15				~ 2 cm thickness	60
13	SILT - some clay to SILT clayey	X	13	3.5	15					65
14										70
15										75
16										80
47										235
48	END OF BOREHOLE 47 m									240
49										245
50										250

COMPLETION DEPTH: 47 m  
 COMPLETE: 3/9/2010  
 Page 1 of 1

C:\Whitehorse\Drawings\Drawings\Ross River\W23103026-01 Community Well Seal Details\W23103026 Fig. 1-2\_R0.dwg [FIGURE 2] November 26, 2012 - 9:15:18 am (BY: BUCHAN, CAMERON)

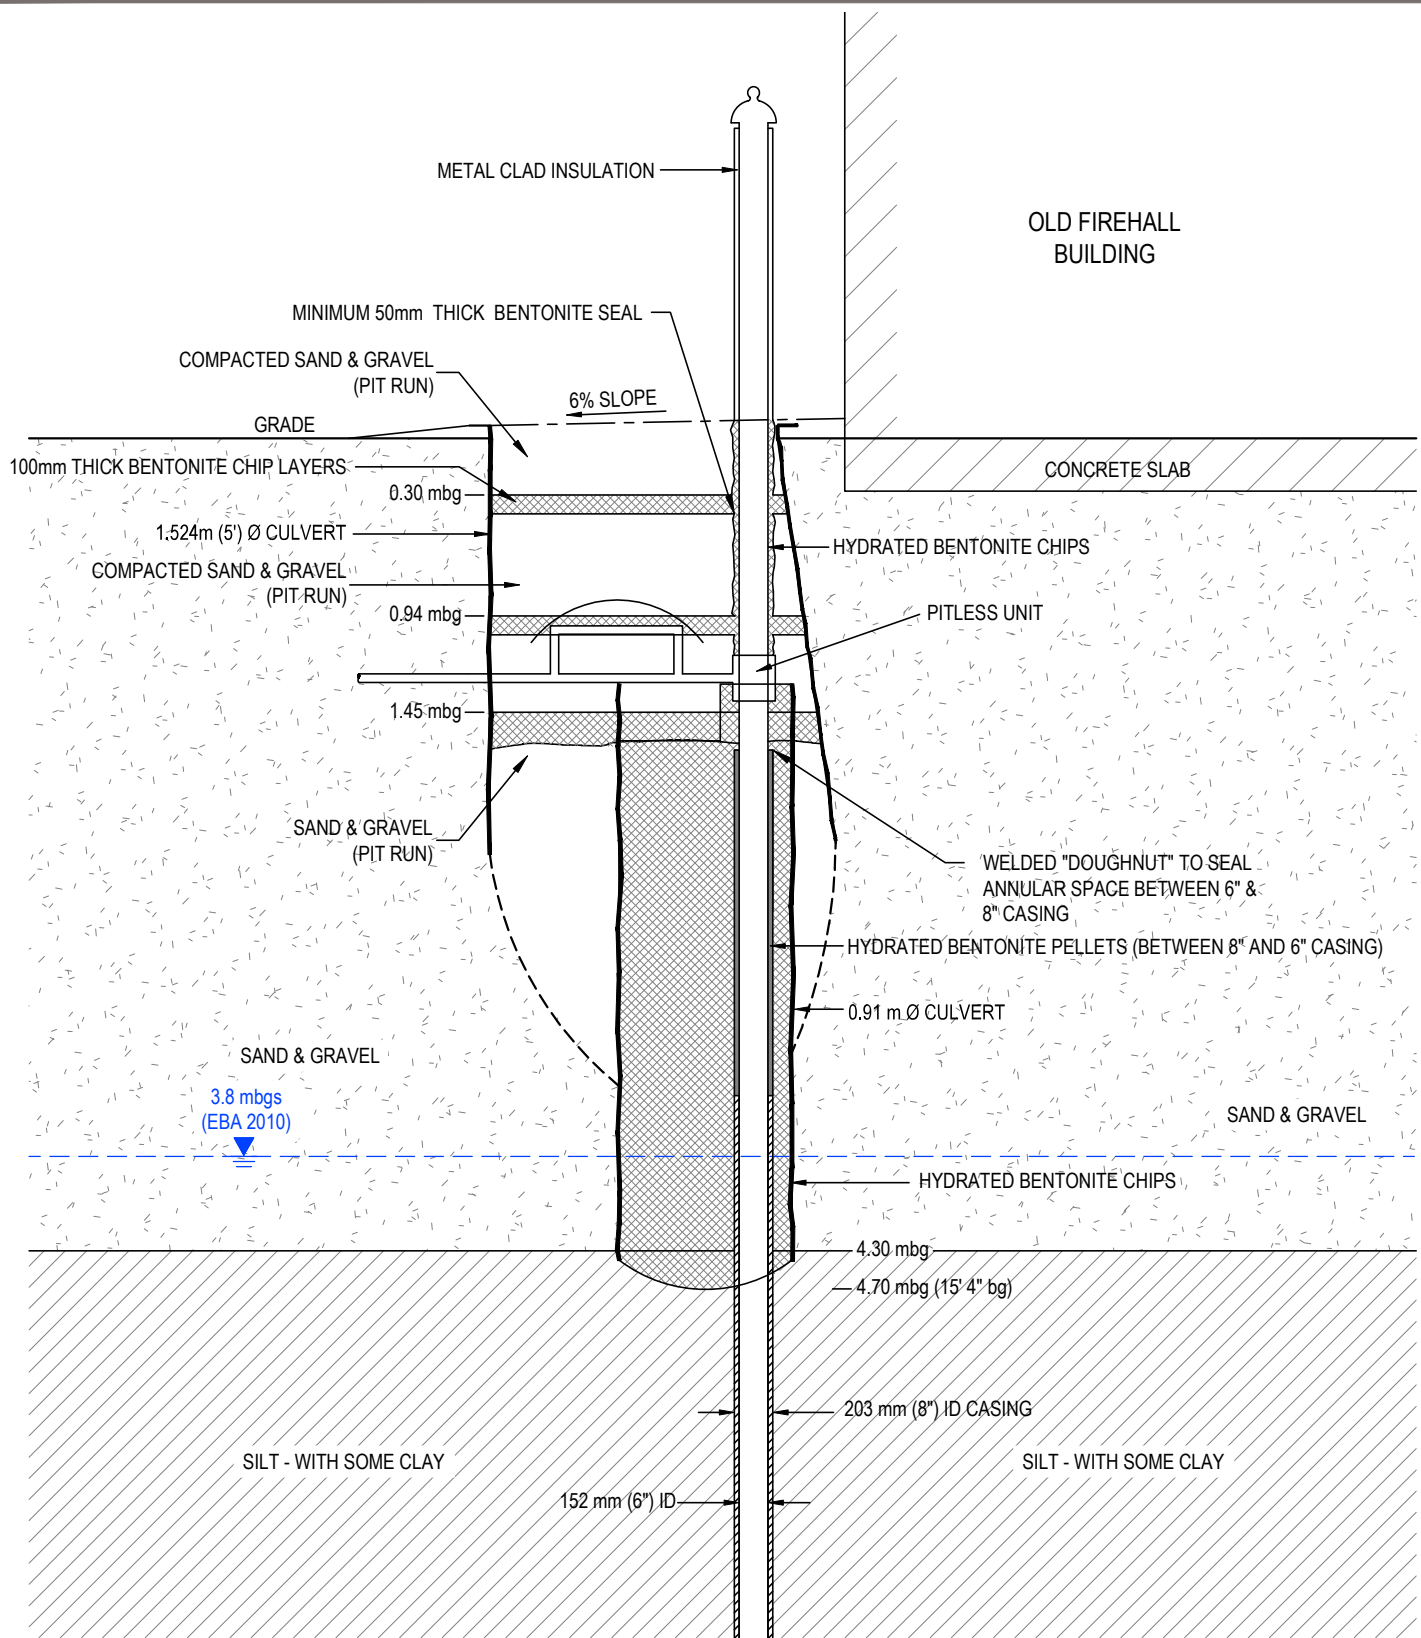

NOTE : COMPACTION WAS LIMITED AROUND AND ABOVE PIPING DUE TO CONCERNS ABOUT ELBOW IN PIPE AND LIMITED AREA IN 5 ft CULVERT. MATERIAL WAS COMPACTED ABOVE PIPE ELBOW AFTER INSTALLING CULVERT SECTION TO PROTECT PIPING.

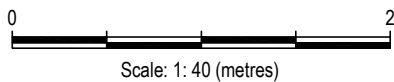

**WELL SEAL - ROSS RIVER COMMUNITY WELL  
ROSS RIVER, YUKON**

**AS-BUILT WELL SEAL DETAILS**

PROJECT NO.	DWN	CKD	REV
			0
OFFICE	DATE		
EBA-WHSE	November 23, 2012		

**Figure 2**